Note:- All pendant Spr's (plaster Ceiling)

(Presidents Office furred Ceil.)

(Board Rm. furred Ceil.)

(Piping Concealed in Board Rm. all spr's pendant plaster Ceiling. (all pipe to be level, lines 6" Ceil (or concrete) to ℄ of pipe)

FIFTH FLOOR

FIFTH FLOOR

LINE NUMBER	NUMBER OF LINES	TOTAL LINES	MAIN LETTER	NUMBER OF PIECES	MARK PIPING
48 to 54	1	5	J	8	I-DASH RED
55	1	1	K	10	
56✓	1	1	L	11	
57	2	2			
58 to 64	1	7	M	9	
65	1	1	N	7	
66	1	1	O	8	
67	1	1	P	12	
68	1	1	R	10	
69	7	7	S✓	12	
70-85	1	16	T✓	8	
86	2	2			NUMBER OF NEW SPRINKLERS THIS FLOOR
87✓	6	6			
88-92	1	5			
93	2	2			
94-100	1	7			

~~Foreman:- Spr's. & piping to be installed at this time to be in ducts & where drop ceilings will conceal piping. Outlets to be plugged in supply to concealed piping. (All to be tested) (All New Duraspeed spr's to be used in ducts)~~

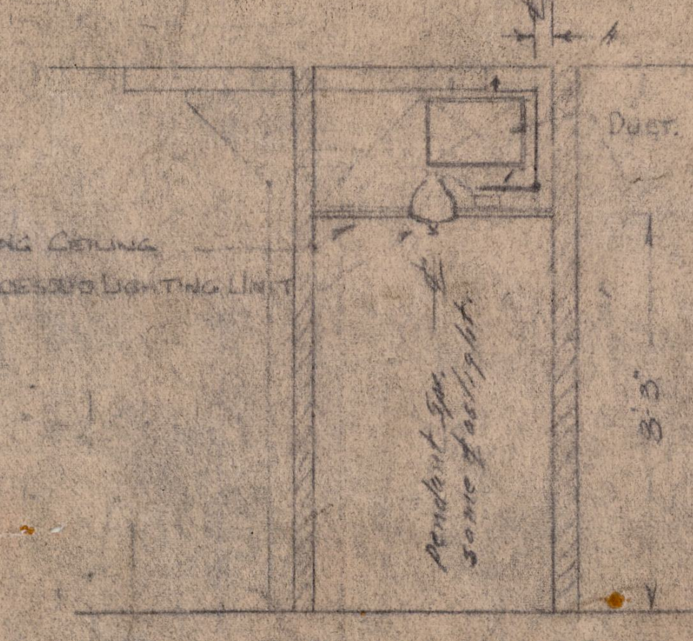

SECTION THROUGH CARRIDOR

Total Spr's Installed 140

(Revised Mar. 20/943)

~~109~~ 107 Spr's To Be Installed when Pipe is Available. MAY 1944

R.C.A. VICTOR CO., LTD.
LENOIR STREET.
MONTREAL, QUE.

No. 17 E BUILDING
FIFTH FLOOR

SCALE:- 1/8"=1'-0" DATE:- DECEMBER, 1942

CONTRACT No. 21-F.P. ~~695~~ 761

PLAN No. G. 78 7-A

GRINNELL COMPANY OF CANADA, LTD.
INSTALLATION DIVISION
MONTREAL, QUE.

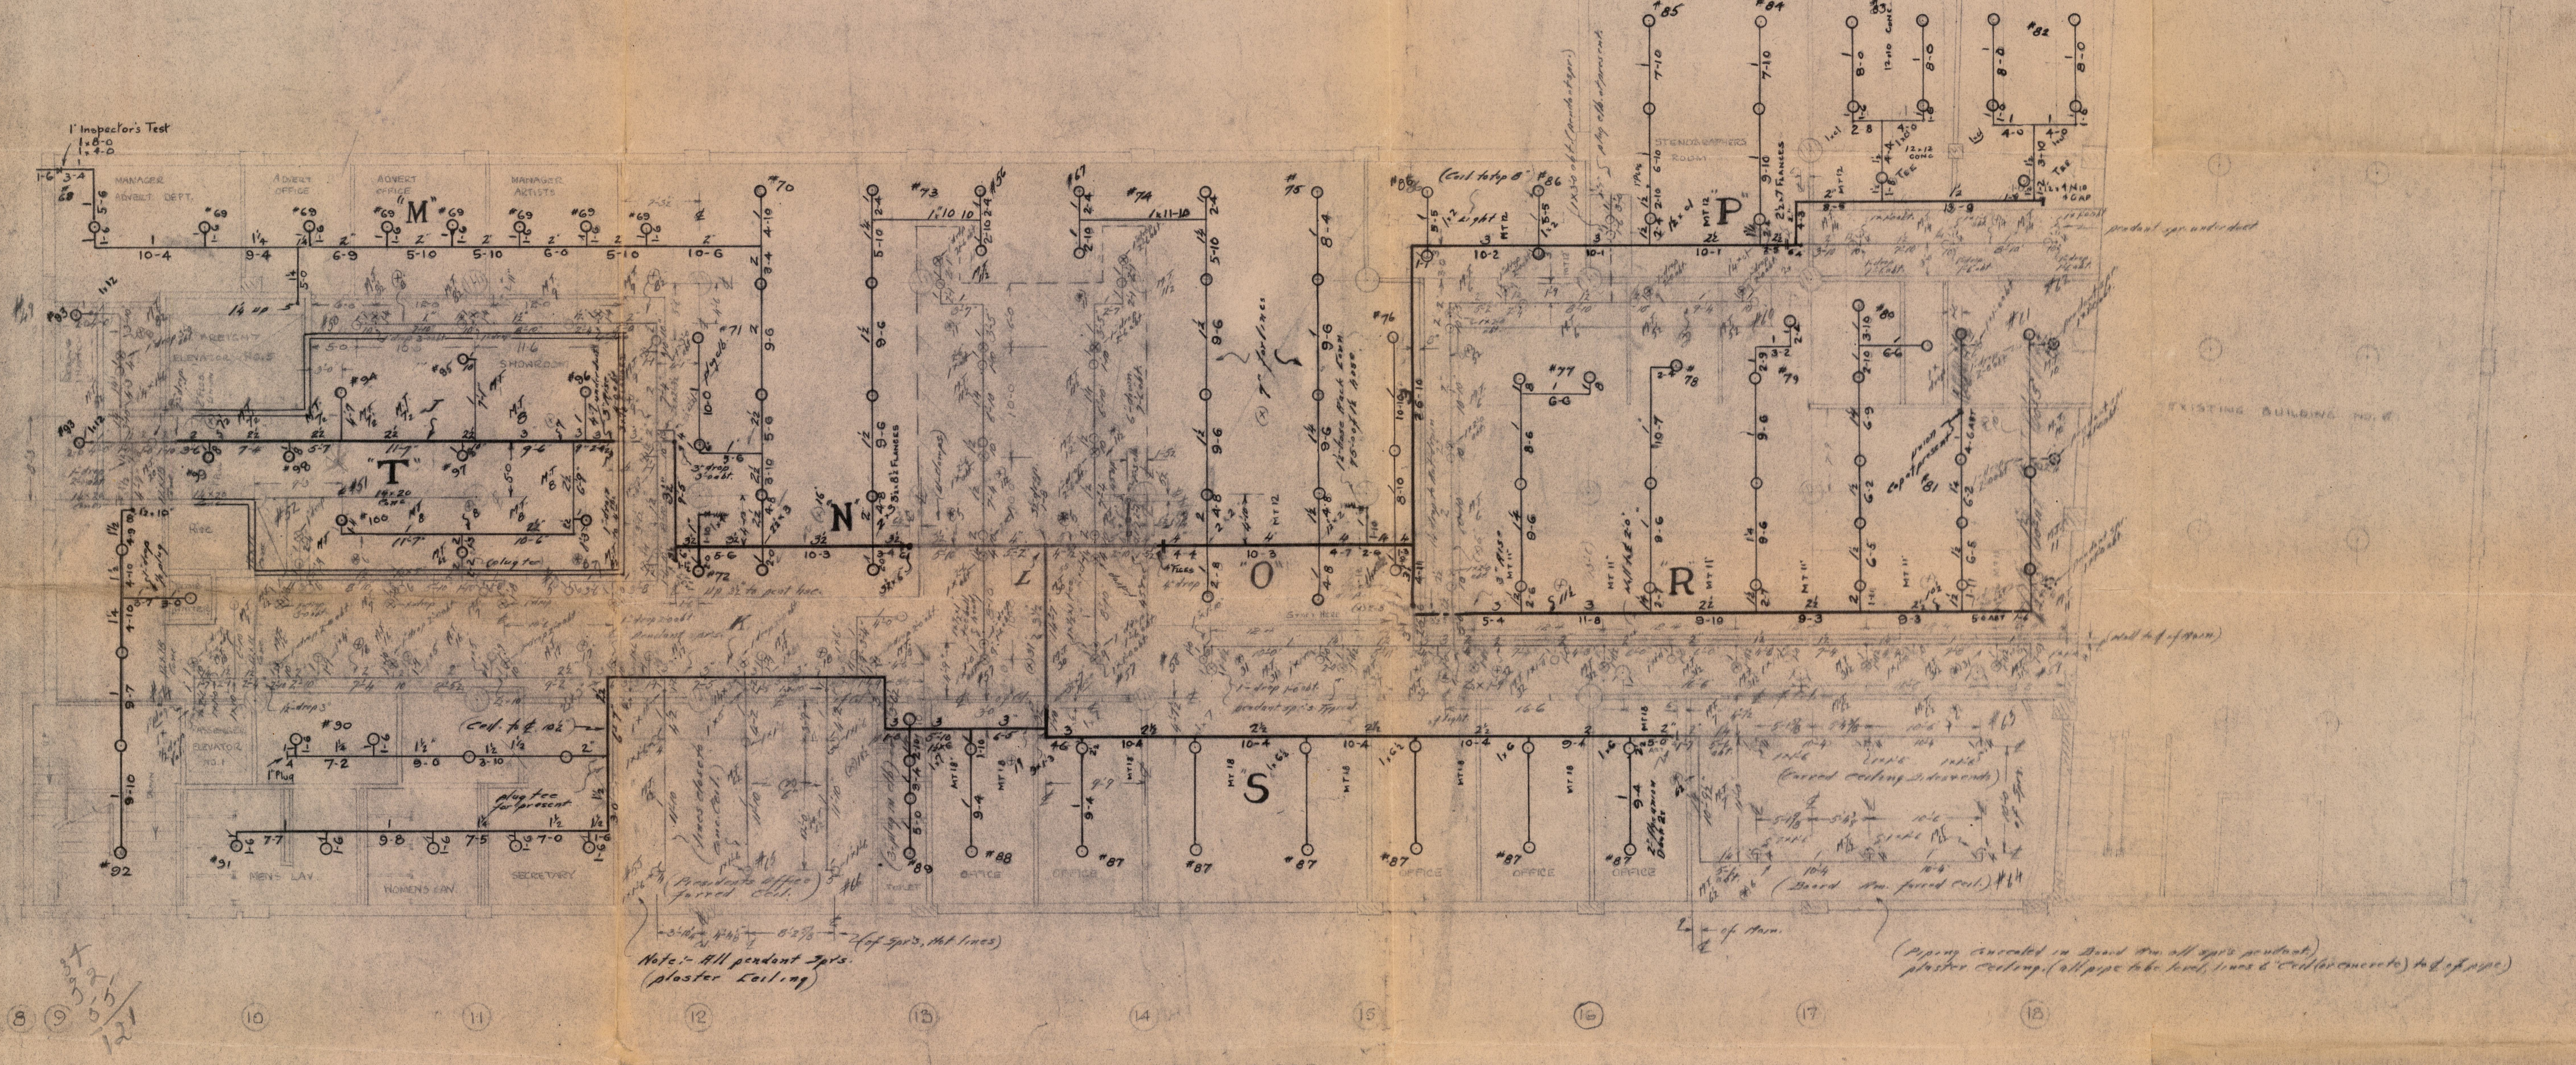

FIFTH FLOOR

~~Foremen:- Spr's & piping to be installed at this time to be in ducts & where drop ceilings will conceal piping. Outlets to be plugged in supply to concealed piping. (All to be tested)~~
~~(All New Duraspeed spr's to be used in ducts)~~

FIFTH FLOOR

LINE NUMBER	NUMBER OF LINES	TOTAL LINES	MAIN LETTER	NUMBER OF PIECES	MARK PIPING
49 to 54	1	5	J	8	1-DASH RED
55	1	1	K	10	
56✓	1	1	L	11	
57	2	2			
58 to 64	1	7	M	9	
65	1	1	N	7	
66	1	1	O	8	
67	1	1	P	12	
68	1	1	R	10	
69	7	7	S✓	12	
70-85	1	16	T✓	8	
86	2	2			NUMBER OF NEW SPRINKLERS THIS FLOOR
87✓	6	6			
88-92	1	5			
93	2	2			
94-100	1	7			

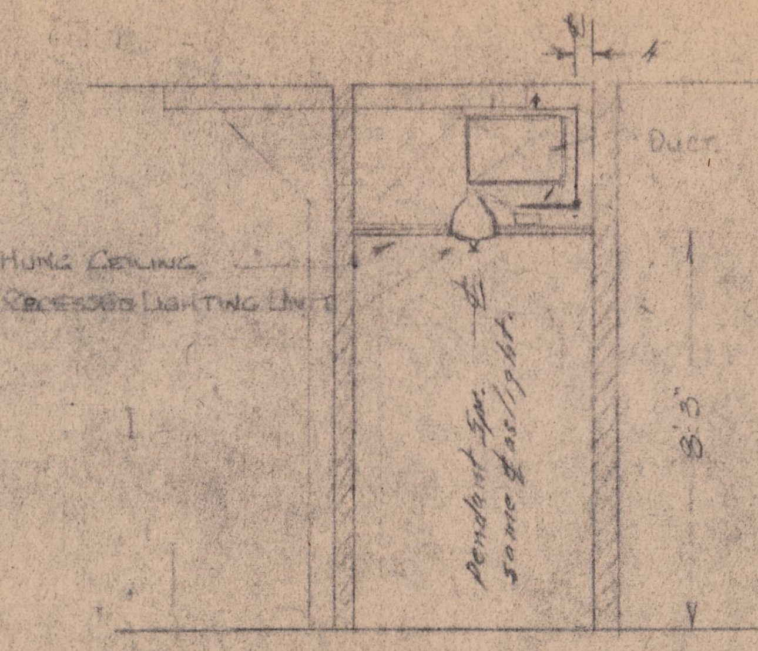

SECTION THROUGH CORRIDOR

Total Sprs Installed 140

(Revised Mar. 20/1943)

107 ~~209~~ Sprs To Be Installed, when Pipe is Available. MAY 1944

R. C. A. VICTOR CO. LTD.
LENOIR STREET.
MONTREAL, QUE.

No. 17 E BUILDING
FIFTH FLOOR

SCALE: 1/8"=1'-0" DATE: DECEMBER 1942

CONTRACT No 21-F.P.-~~685~~ 761

PLAN No G.C. 78-7-A

GRINNELL COMPANY OF CANADA, LTD.
INSTALLATION DIVISION
MONTREAL, QUE.

127
70
197
8
205
10
1" Inspector's Test
"M"
"T"
"N"
"O"
"P"
"R"
"S"
FREIGHT ELEVATOR HOIST
SHOWROOM
STENOGRAPHERS ROOM
EXISTING BUILDING No. 6
MEN'S LAV
WOMEN'S LAV
SECRETARY
OFFICE
(Presidents Office furred Ceil.)
(Board Rm. furred Ceil.)
Note:- All pendant Sprs. (plaster Ceiling)
(Piping Concealed in Board Rm. all sprs pendant. plaster Ceiling. (all pipe to be level, lines 6" Ceil (or concrete) to ℄ of pipe)
8
9
10
11
12
13
14
15
16
17
18

FIFTH FLOOR

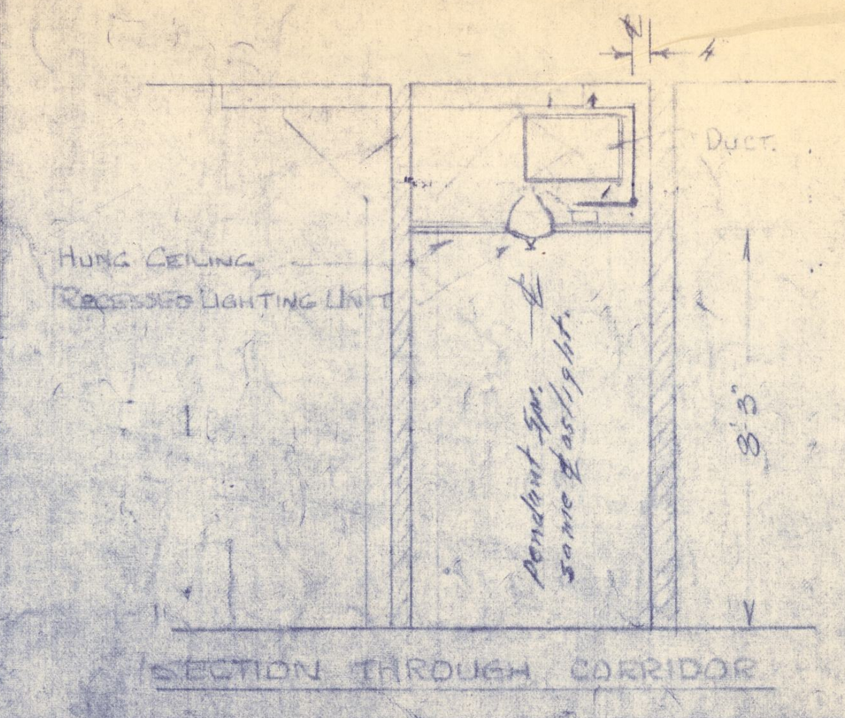

SECTION THROUGH CORRIDOR

FIFTH FLOOR

LINE NUMBER	NUMBER OF LINES	TOTAL LINES	MAIN LETTER	NUMBER OF PIECES	MARK PIPING
49 to 54	1	5	J	8	1-DASH RED
55	1	1	K	10	
56✓	1	1	L	11	
57	2	2			
58 to 64	1	7	M	9	
65	1	1	N	7	
66	1	1	O	8	
67	1	1	P	12	
68	1	1	R	10	
69	7	7	S✓	12	
70-85	1	16	T✓	8	
86	2	2			NUMBER OF NEW SPRINKLERS THIS FLOOR
87	6	6			
88-92	1	5			
93	2	2			
94-100	1	7			

Total Sprs Installed 140

107 ~~100~~ Sprs To Be Installed when Pipe is Available. MAY 1944

DEC 21 1953

CONTRACT No. 21 F.P. ~~685~~ 761

PLAN No G.C. 78 7-A

(Revised Mar. 20/943)

R. C. A. VICTOR CO., LTD.
LENOIR STREET.
MONTREAL. QUE.

No. 17 E BUILDING
FIFTH FLOOR

SCALE: 1/8"=1'-0" DATE: DECEMBER 1942

GRINNELL COMPANY OF CANADA, LTD.
INSTALLATION DIVISION
MONTREAL, QUE.

Note:- All pendant Sprs. (plaster Ceiling)

(Piping Concealed in Board Rm. all spr's pendant.) plaster Ceiling. (all pipe to be level, lines 6" Ceil (or concrete) to ℄ of pipe.)

FIFTH FLOOR

FIFTH FLOOR

LINE NUMBER	NUMBER OF LINES	TOTAL LINES	MAIN LETTER	NUMBER OF PIECES	MARK PIPING
49 to 54	1	5	J	8	1-DASH RED
55	1	1	K	10	
56✓	1	1	L	11	
57	2	2			
58 to 64	1	7	M	9	
65	1	1	N	7	
66	1	1	O	8	
67	1	1	P	12	
68	1	1	R	10	
69	7	7	S✓	12	
70-85	1	16	T✓	8	
86	2	2			NUMBER OF NEW SPRINKLERS THIS FLOOR
87	6	6			
88-92	1	5			
93	2	2			
94-100	1	7			

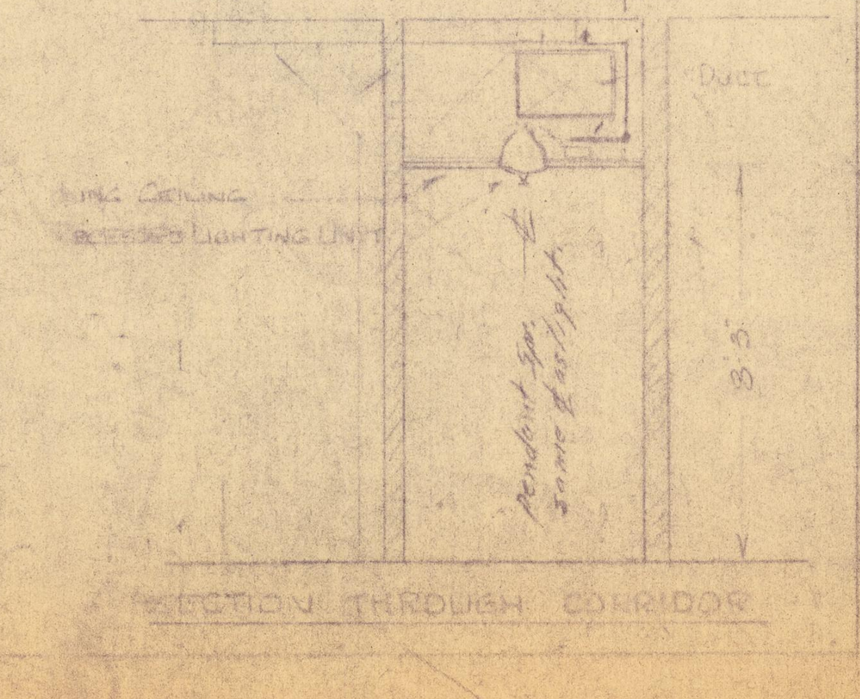

SECTION THROUGH CORRIDOR

Total Sprs Installed 140

~~209~~ 107 Sprs To Be Installed when Pipe is Available. MAY 1944

(Revised Mar. 20/1943)

R. C. A. VICTOR CO. LTD.
LENOIR STREET.
MONTREAL. QUE.

NO. 17 E BUILDING
FIFTH FLOOR

SCALE: 1/8"-1'-0" DATE: DECEMBER 1942

CONTRACT NO. 21. F.P. ~~695~~ 761

PLAN NO. G.C. 78 7-A

GRINNELL COMPANY OF CANADA LTD.
INSTALLATION DIVISION
MONTREAL QUE.